


OAK SPRINGS PROJECT

THIS DRAWING DOES NOT REPRESENT A RECORD DOCUMENT, UNLESS CERTIFIED BY HATTON GODAT PANTIER.

ANY ALTERATIONS TO THE DESIGN SHOWN HEREON MUST BE REVIEWED AND APPROVED BY HATTON GODAT PANTIER.

NOTE: THE CONTRACTOR SHALL BE FULLY RESPONSIBLE FOR THE LOCATION AND PROTECTION OF ALL EXISTING UTILITIES. THE CONTRACTOR SHALL VERIFY ALL UTILITY LOCATIONS PRIOR TO CONSTRUCTION BY CALLING THE UNDERGROUND LOCATE LINE AT 811 A MINIMUM OF 48 HOURS PRIOR TO ANY EXCAVATION.

- NOTE:
- ① S.T.E.P. TANKS NEED A MINIMUM OF 5' CLEARANCE ON ALL SIDES.
 - ② WHERE 2 TANKS ARE INSTALLED BACK TO BACK AT A COMMON PROPERTY LINE THE TANKS WILL BE INSTALLED WITH A MINIMUM OF 5' OF SEPARATION (2.5' EACH SIDE OF COMMON PROPERTY LINE).
 - ③ ALL TREES PLANTED IN YARDS SHALL BE A MINIMUM OF 10' FROM S.T.E.P. TANKS.

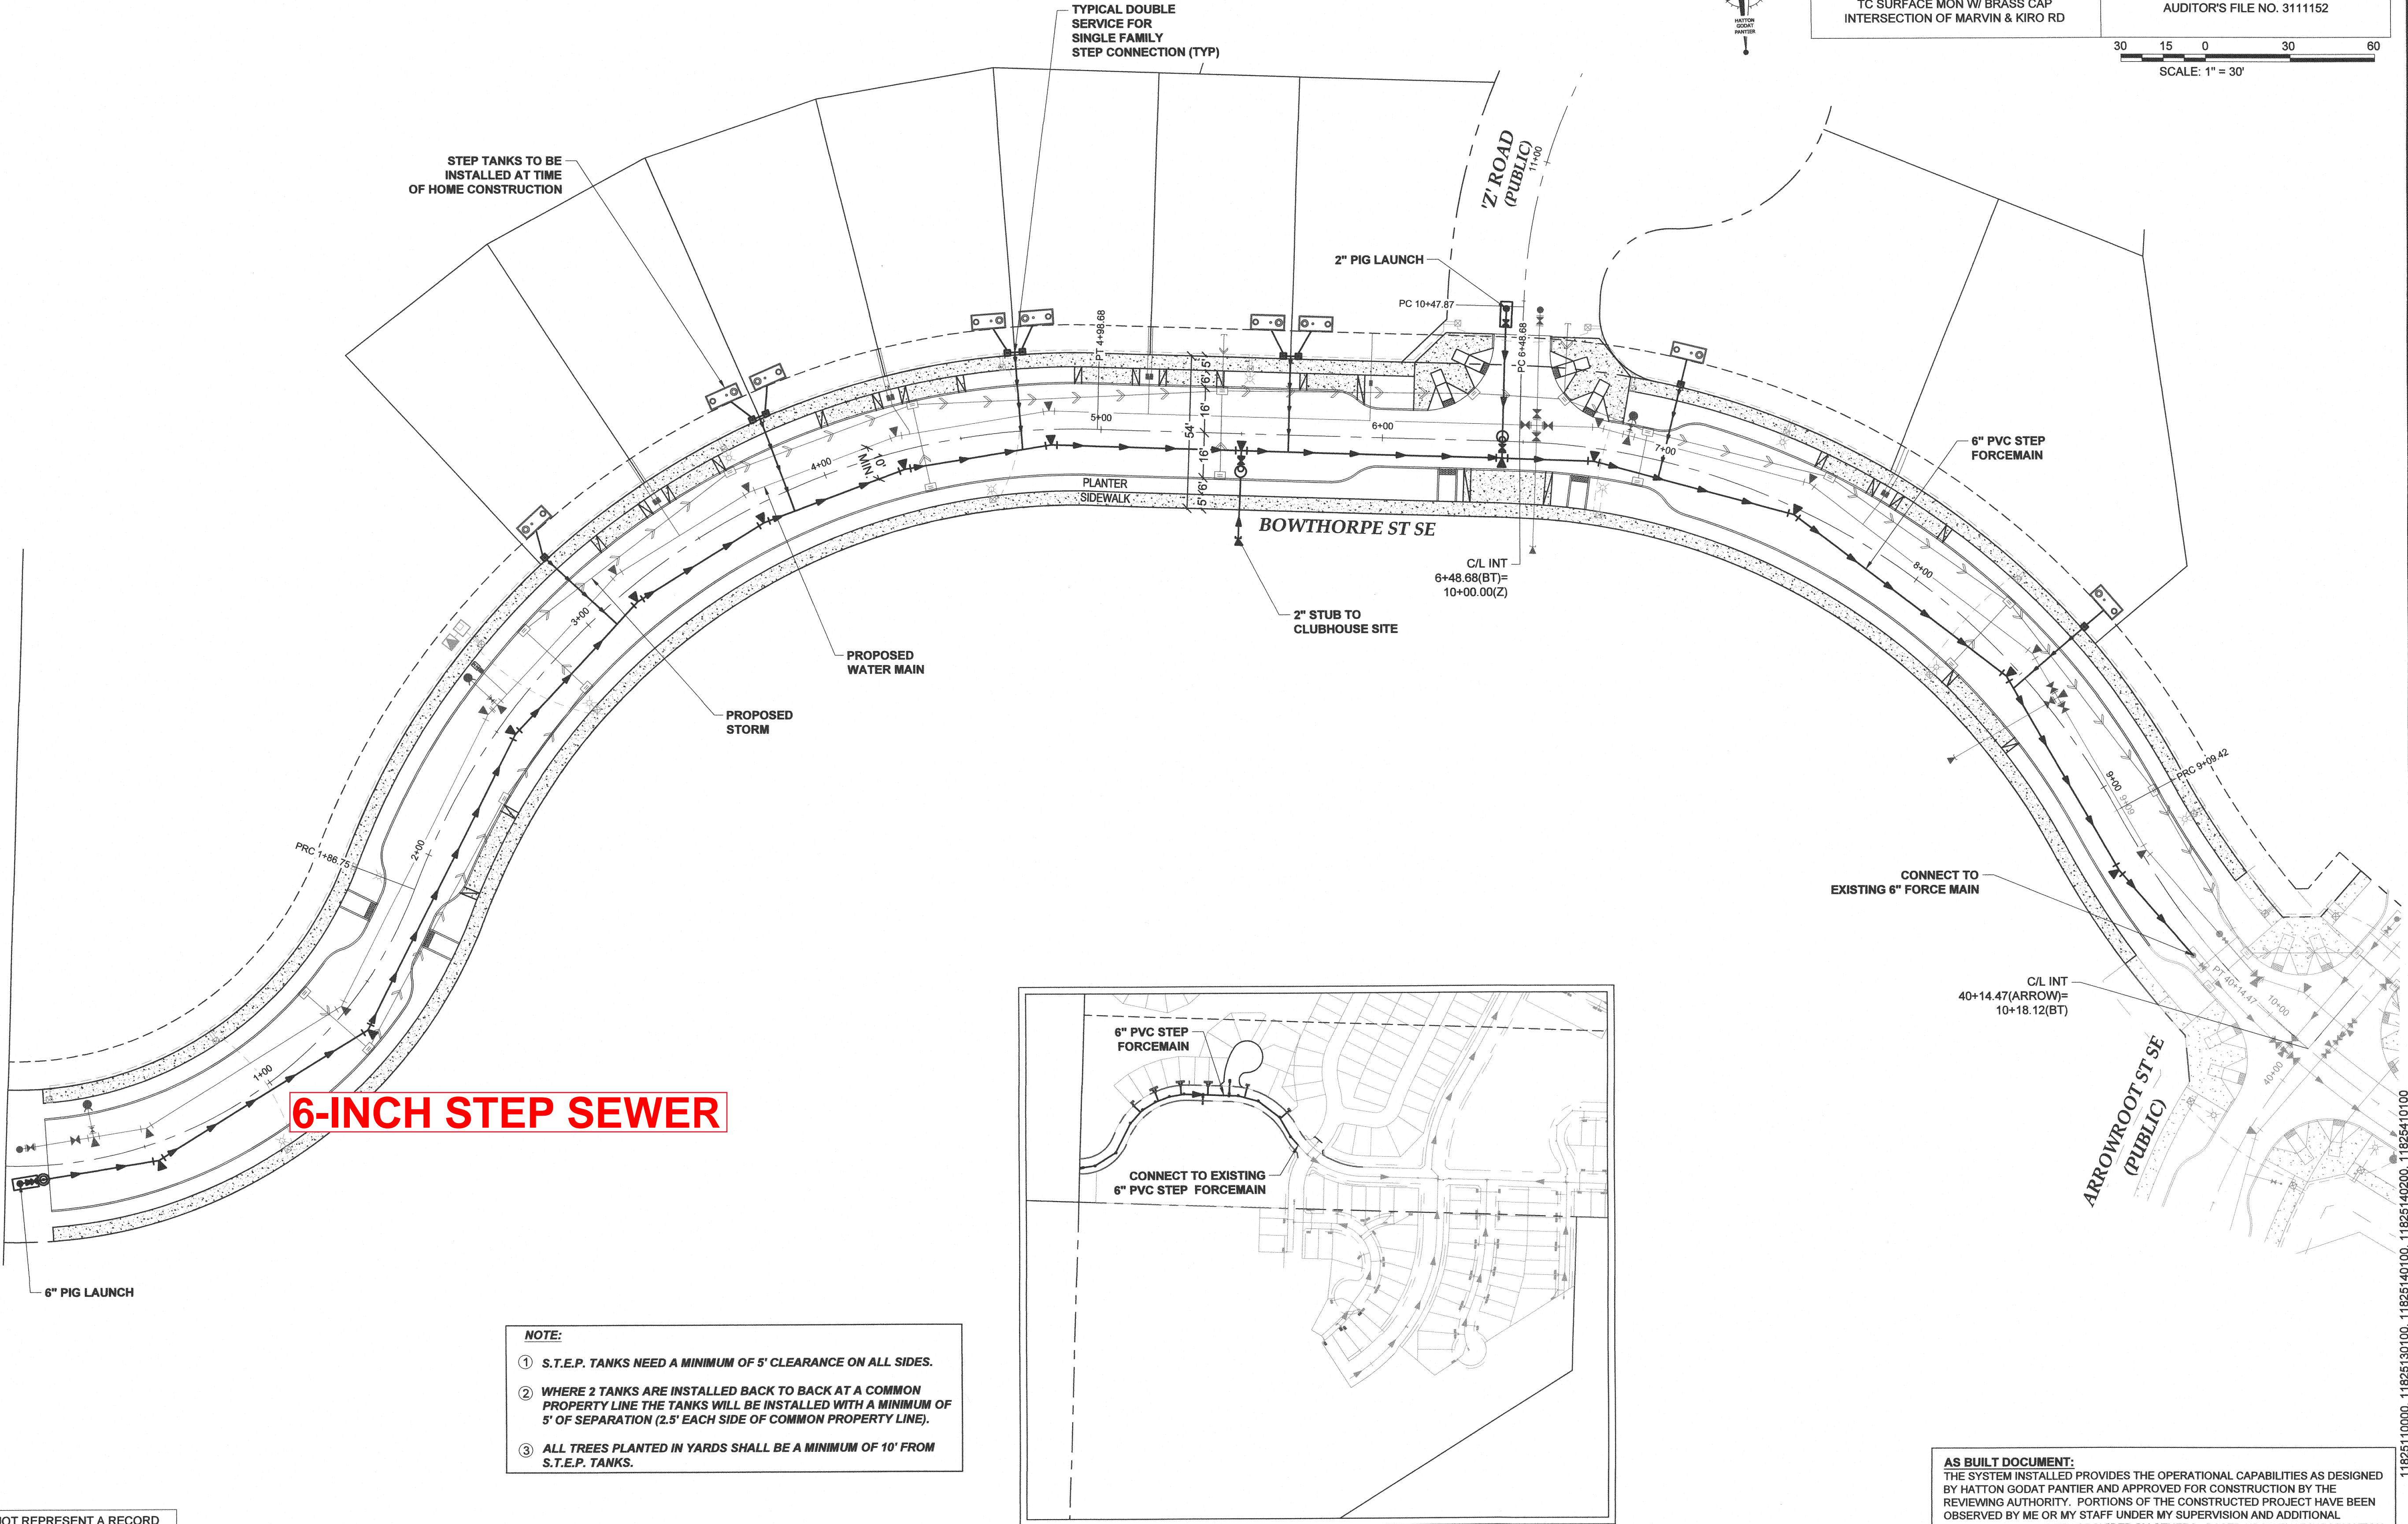

SEWER SYSTEM MAP


1" = 300'

AS BUILT DOCUMENT:

THE SYSTEM INSTALLED PROVIDES THE OPERATIONAL CAPABILITIES AS DESIGNED BY HATTON GODAT PANTIER AND APPROVED FOR CONSTRUCTION BY THE REVIEWING AUTHORITY. PORTIONS OF THE CONSTRUCTED PROJECT HAVE BEEN OBSERVED BY ME OR MY STAFF UNDER MY SUPERVISION AND ADDITIONAL INFORMATION HAS BEEN PROVIDED BY OTHERS. BASED UPON THAT INFORMATION AND OBSERVATION, TO THE BEST OF MY KNOWLEDGE, THE PROJECT WAS CONSTRUCTED SUBSTANTIALLY IN ACCORDANCE WITH THESE DRAWINGS.

SIGNATURE: *[Signature]* DATE: 11/3/20

DESIGNED BY: CPM/KNC
DRAWN BY: BSM/MJM
CHECKED BY: SDH
DATE: APRIL 2019
SCALE: 1" = 30'

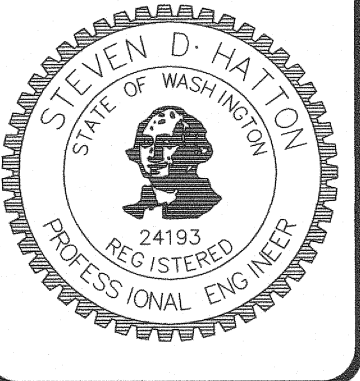

HATTON GODAT PANTIER
AND SURVEYORS
ENGINEERS
3910 MARTIN WAY E, SUITE B
OLYMPIA, WA 98506
TEL: 360.943.1599 FAX: 360.357.6299
hattonpantier.com

REVISIONS	DATE
GRADE REVISIONS	04/25/2019

BOWTHORPE RIGHT OF WAY IMPROVEMENTS
MARVIN ROAD SE, LACEY, WA 98503

OVERALL SEWER PLAN

A PORTION OF THE SE 1/4 OF THE SW 1/4 AND THE SW 1/4 OF THE SE 1/4 OF SECTION 3 AND A PORTION OF THE NW 1/4 OF THE NE 1/4 OF SECTION 10, TOWNSHIP 18 NORTH, RANGE 1 WEST, W.M.

LACEY NO. 12-239
THURSTON NO. 2009103087
SHEET: 20 OF 28
E:\dgn\12-000\12-061\12-061Y\As-Built\12-061Y-sew.dwg
INDEX: 12-061Y
JOB: 12-061Y